



City of Tuscaloosa

Purchasing Division
2201 University Blvd
Tuscaloosa, AL 35401
Phone: (205) 248-5170

BID ADDENDUM NO. 1 JANUARY 27, 2016

MINOR PUBLIC WORKS BID A16-0055 CITY HALL ADDITIONAL SIGNAGE REPLACEMENT

Change #1:

Due to the specification changes to follow in this document, the deadline for accepting bids and the bid opening time have been changed. The new date and time shall be as follows:

Monday, February 1, 2016 at 2:00 PM

Change #2:

Delete original Signage Specifications (11 pages) and replace with the Revised Signage Specifications (11 pages) that are attached.

If you have any questions, please contact me at (205) 248-5186 or

dcoggins@tuscaloosa.com

Thank you,

**David Coggins
Purchasing Agent
City Of Tuscaloosa**



2715 7th Street
Tuscaloosa, Alabama 35401
T: 205.345.6110
F: 205.345.6696

REQUEST FOR PROPOSAL

NO.: 1R


OWNER: The City of Tuscaloosa 2201 University Boulevard, Tuscaloosa, AL 35401	PROJECT: City of Tuscaloosa Signage Replacement	PROJ NO.: 13-008
---	--	-------------------------

DESCRIPTION:


1. Provide replacement signs Type E.3 copy to read: "Office of Resilience and Innovation". Provide replacement sign Type E.3 copy to read: "Office of Federal Programs". Provide replacement sign Type E.3 copy to read: "Garner Conference Room" Include removal of old signage of identical size. Locations as directed by owner/architect. Provide new sign Type E.3 with copy to read: "Janitor" at Reference Photo #5.
2. Provide an additional 4 Type C.3-1S signs and One Type C.4 sign at locations indicated on the attached Revised Sheets A122, A123 and A143.
3. Provide a quantity of ~~five~~ **seven** Type E.4x Signs as indicated on the attached to be installed at locations within the facility as directed by the Owner and/or Architect to replace existing No Smoking Signs. Include sign removal, patching and touchup painting at existing signs.
4. Provide a quantity of 100 Type E.3x .080 Aluminum Exterior Signs with adhesive mounting as required for exterior installation at locations at various facilities as directed by the Owner.
5. Provide signage removal and wall patching at 1 required location as indicated in the attached Reference Photo #1 and signage removal at Reference Photo #5.
6. Provide new Type E.3x Alternate Layout sign at door indicated at Reference Photo #6 to replace insert sign on wall adjacent to door. Remove all existing signage on door at Reference Photo #6 and patch and repaint door.
7. Provide wall patching at new signs at 10 required locations (1 Large – Reference Photo #3, 8 Small – Reference Photo #7, and 2 Very Large – Reference Photo #8, City Hall Lobby and Annex I Lobby).
8. Provide ~~One~~ **TWO** Type A.2 replacement signs at location indicated at Reference Photo #4 **and as directed by the architect.**
9. Provide Six Type A.1 replacement signs at locations indicated at Reference Photo #2. Insert copy as indicated on the attached list of copy.
10. Provide two new E.3 signs for installation at City Hall Annex I Second Floor. Copy to be selected.
11. Provide two new Type E.4x Alternate Layout Signs with Copy reading "Use Annex III Entrance on 6th Street" for installation at Annex I basement east and south doors.

ATTACHMENTS:
 Elevations of signage types.
 Photos of required signage and Specified Copy at Type A.1 signs.
 Revised Drawings A122, A123 and A143


REQUESTED BY: OWNER

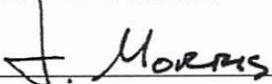Signature: 

Printed Name and title: Jordan C. Morris, Project Manager
Ward Scott Architecture

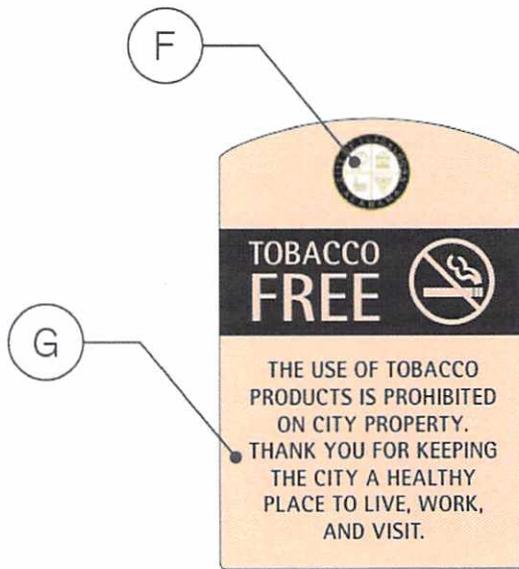


Type E.4x Custom
 8.5"w X 12.5"h
 Vivid Construction
 Exterior

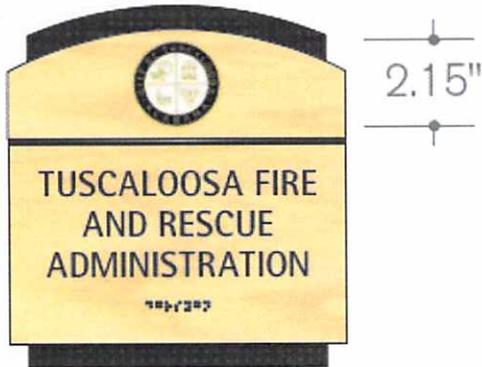

Type E.3 F29B-F2
 8.5"w X 9.0"h



Type E.3x Custom
 6.0"w X 6.75"h
 Vivid Construction
 Exterior

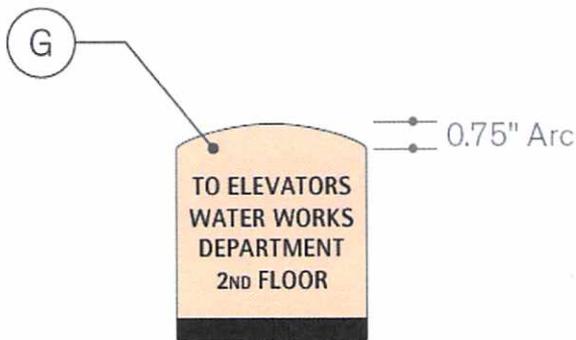

Type E.3x *Alternate Layout*
 Vivid Construction
 Exterior

• Betty Bowles	101	•
• Carolyn Carter	102	•
• Virginia Thomas	103	•
• Hildred Whittum	104	•
• Evelyn Goodrich	200	•
• Marian Walsh	201	•
• Dorothy Van Vorst	202	•
•		•

Type A1 CD508C-1
 22"w X 13.75"h

Insert Detail


Paper insert printed with graphic to remain in place

Clear insert printed with names to be changable


Betty Bowles	101
Carolyn Carter	102
Virginia Thomas	103
Hildred Whittum	104
Evelyn Goodrich	200
Marian Walsh	201
Dorothy Van Vorst	202

• Betty Bowles	101	•
• Carolyn Carter	102	•
• Virginia Thomas	103	•
• Hildred Whittum	104	•
• Evelyn Goodrich	200	•
• Marian Walsh	201	•
• Dorothy Van Vorst	202	•
• Betty Bowles	101	•
• Carolyn Carter	102	•
• Virginia Thomas	103	•
• Hildred Whittum	104	•
• Evelyn Goodrich	200	•
• Marian Walsh	201	•
• Dorothy Van Vorst	202	•
•		•
•		•
•		•
•		•

Type A2 CD518C-1
22"w X 30.0"h

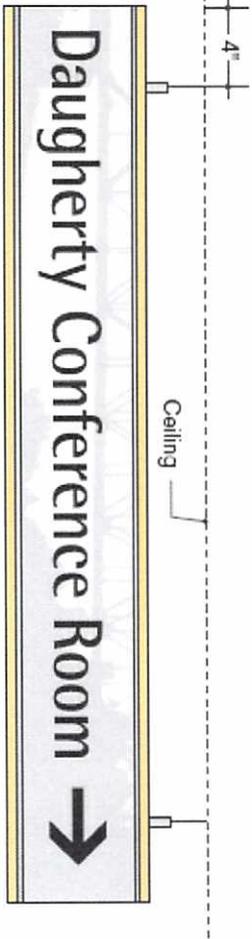

Type C.3-1S V7711-3S
 44.0"W X 7.0"H
 Double Sided Overhead, Accommodates Insert

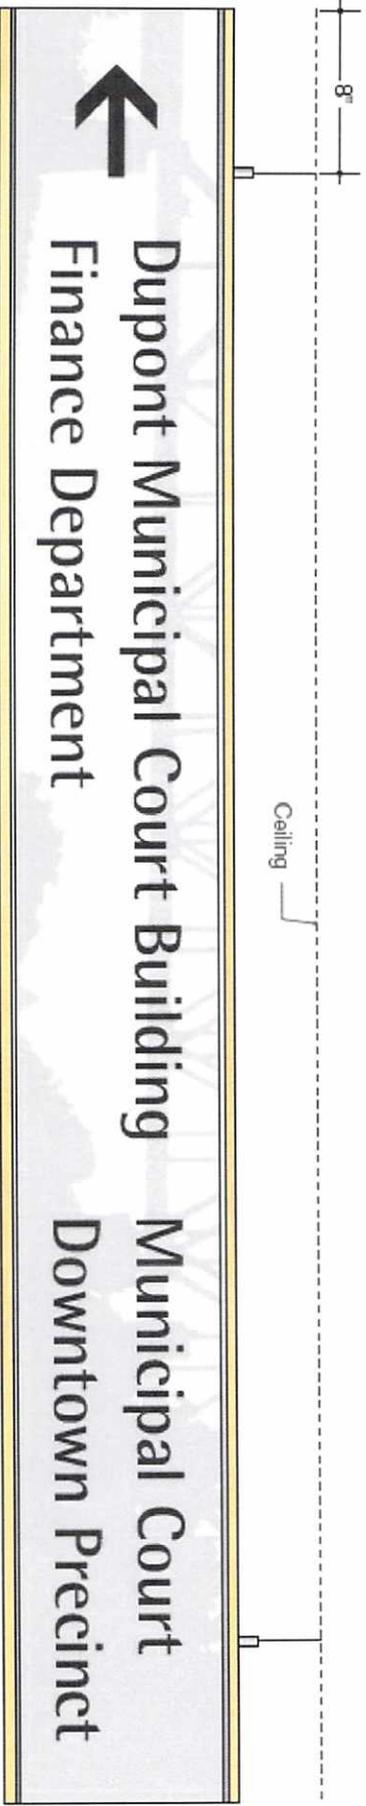

Type C.4 V931-3S
 88.0"W X 11.5"H
 Double Sided Overhead, Accommodates Insert



Reference Photo #1
Remove Redundant Small Signage and patch walls



Reference Photo #2
Replace sign with type A.1.



Reference Photo #3
Required Patching and touch up paint at new signage



Reference Photo #4
Replace existing sign with Type A.2



Reference Photo #5
Match existing copy and braille




Reference Photo #6
Copy: Elevator Lobby; include braille





Reference Photo #7
Patch wall at replaced sign



Reference Photo #8
Patch Wall at removed directory

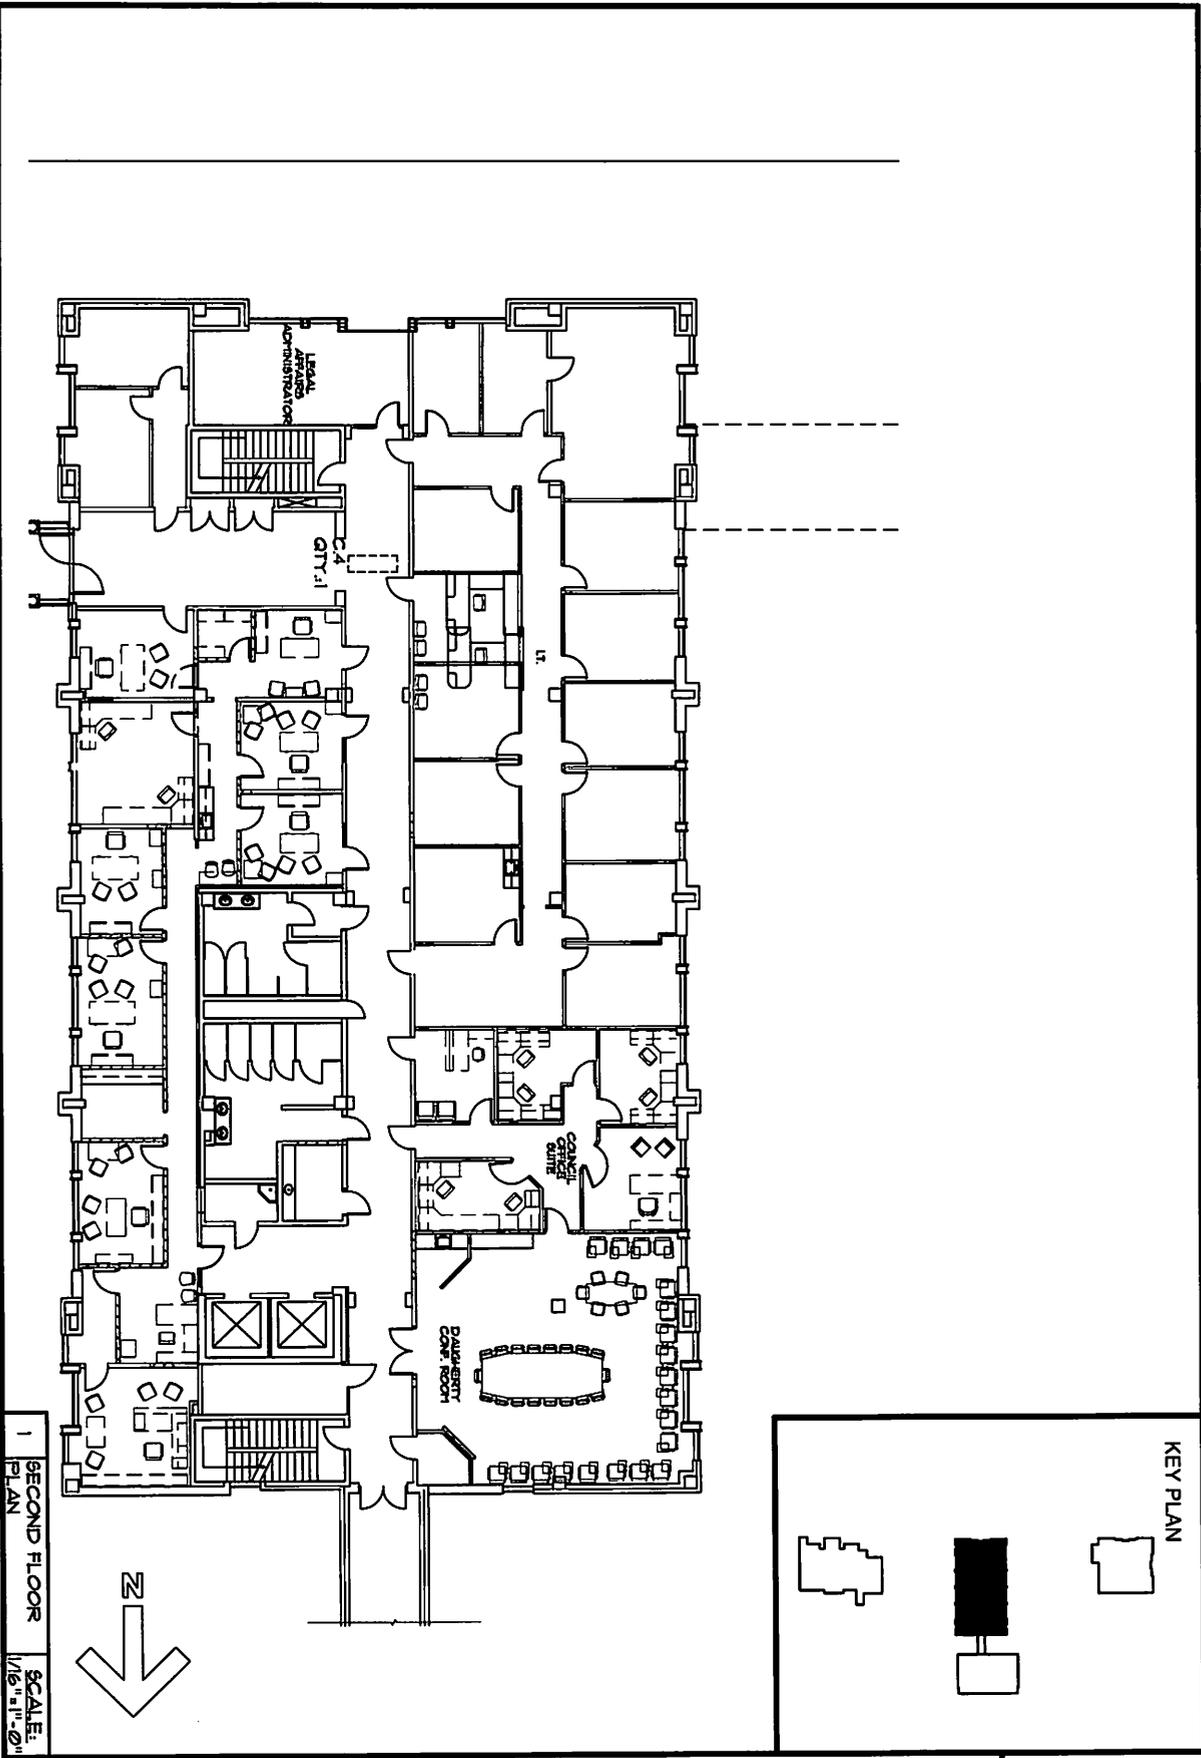

1 SECOND FLOOR PLAN
SCALE: 1/16" = 1'-0"

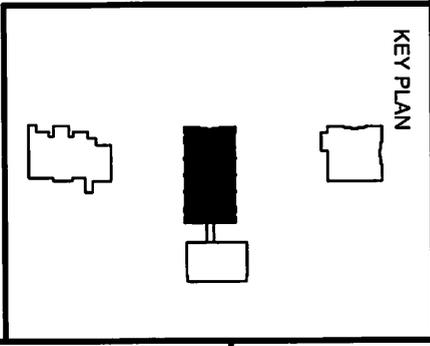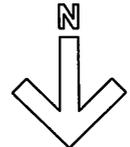


JOB NO.: 13-008 DATE: 1/11/16 REVISION: **A122**

WARD SCOTT
ARCHITECTURE
2715 Seventh Street
Tuscaloosa, AL 35401
www.ward-scott.com



TUSCALOOSA CITY HALL COMPLEX -
SIGNAGE & WAYFINDING RENOVATION
TUSCALOOSA, ALABAMA
CITY OF TUSCALOOSA

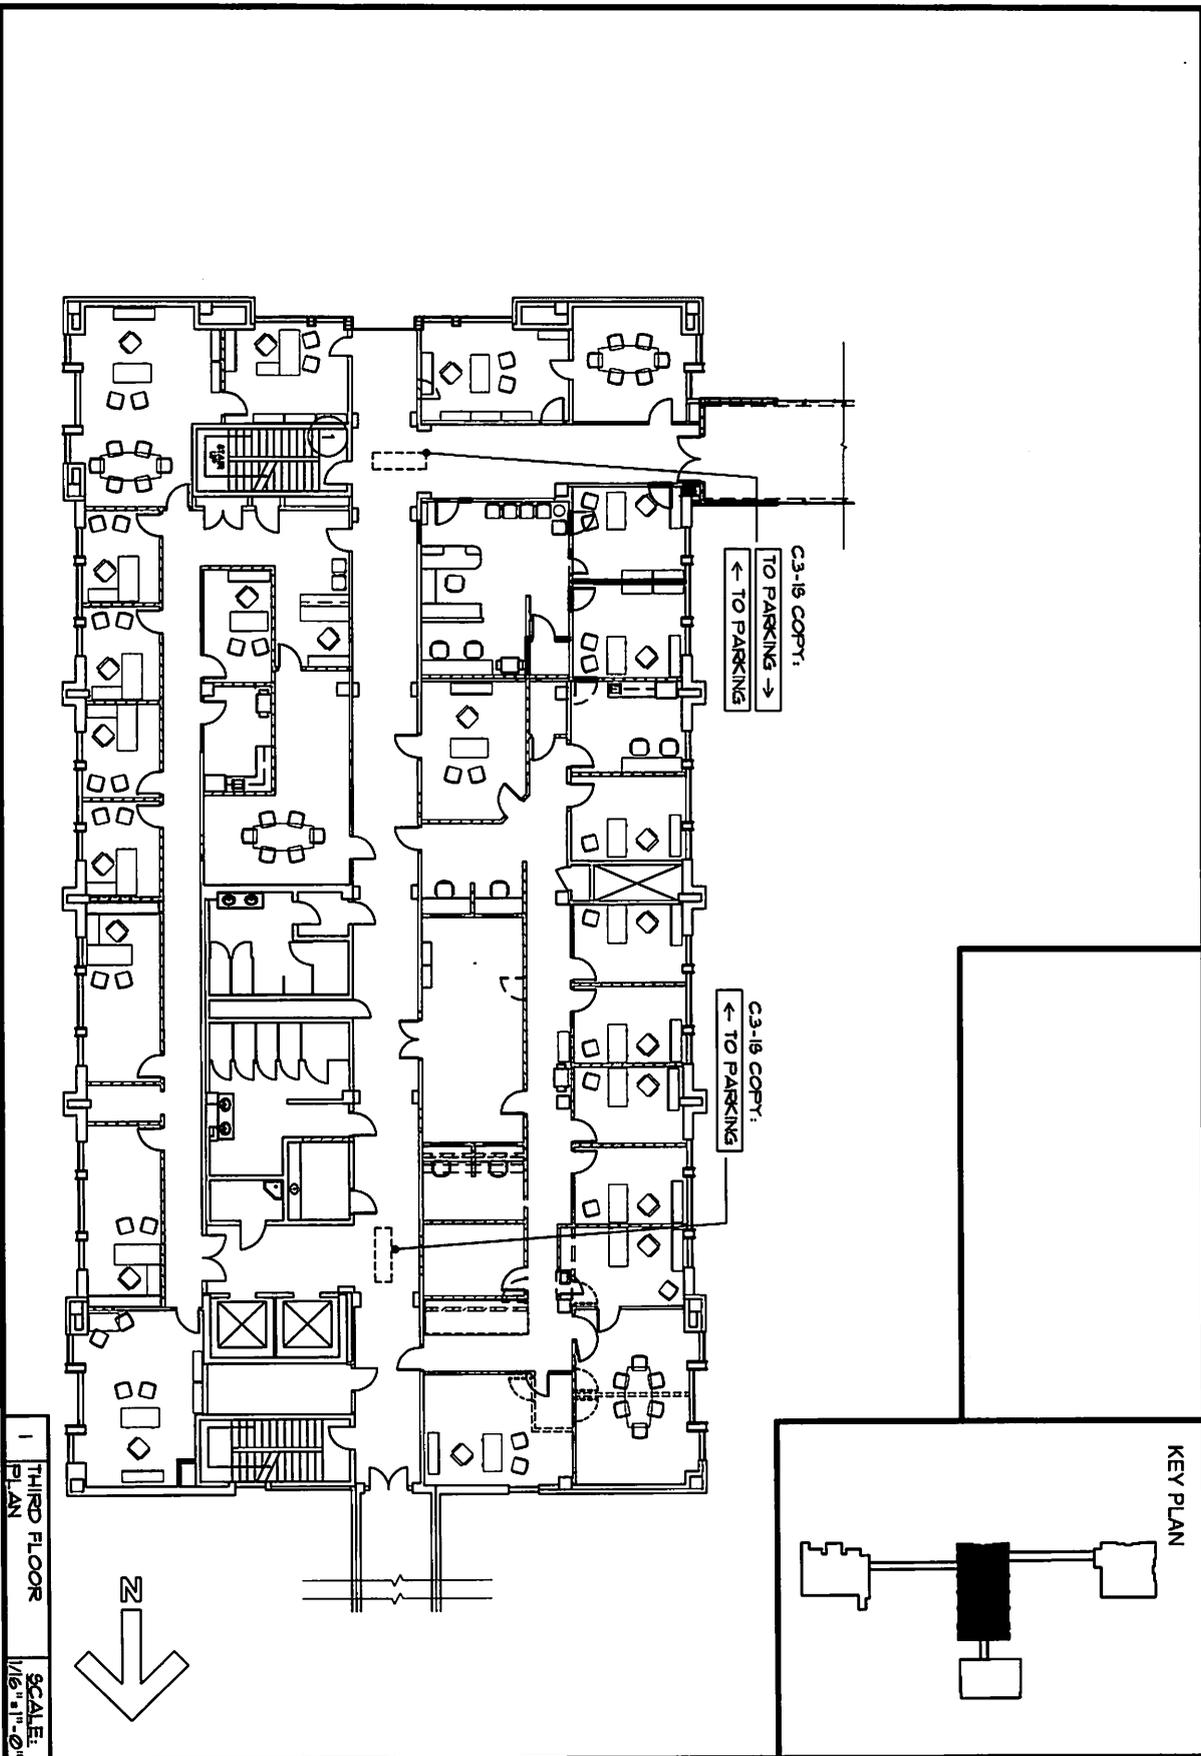

JOB NO.:13-008

DATE: 1/11/16

REVISION:


A123

**WARD
SCOTT**
ARCHITECTURE

2715 Seventh Street
Tuscaloosa, AL 35401
www.ward-scott.com



TUSCALOOSA CITY HALL COMPLEX -
SIGNAGE & WAYFINDING RENOVATION
TUSCALOOSA, ALABAMA
CITY OF TUSCALOOSA

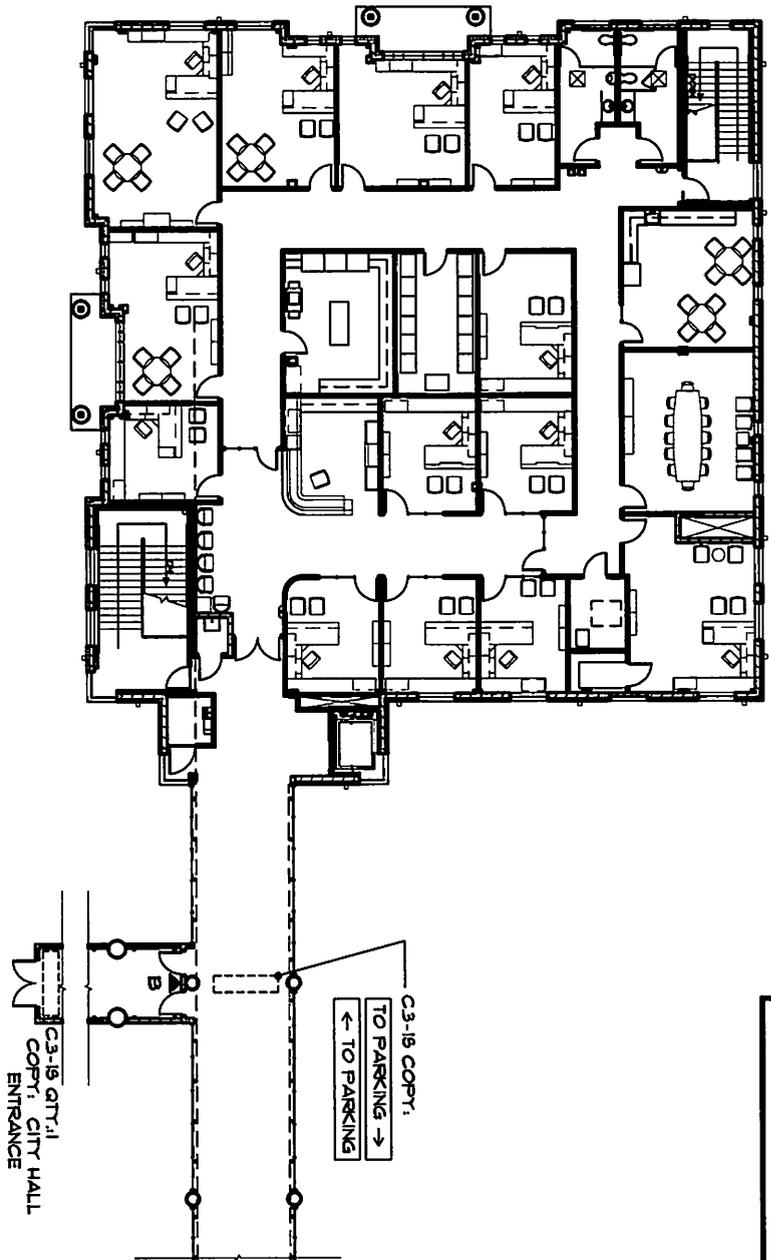

1 THIRD FLOOR PLAN
SCALE: 1/16" = 1'-0"

JOB NO.: 13-008

DATE: 1/11/16


REVISION:

A143


WARD SCOTT ARCHITECTURE
2715 Seventh Street
Tuscaloosa, AL 35401
www.ward-scott.com




TUSCALOOSA CITY HALL COMPLEX -
SIGNAGE & WAYFINDING RENOVATION
TUSCALOOSA, ALABAMA
CITY OF TUSCALOOSA

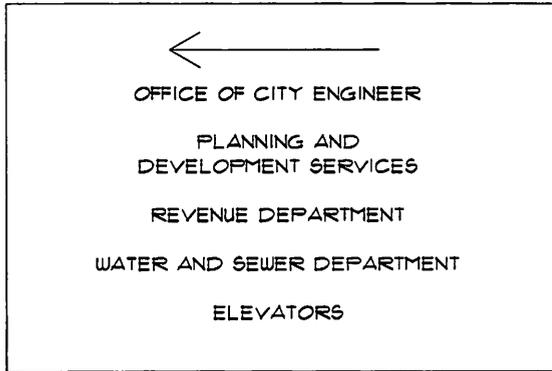


3RD FLOOR BY OCA ENTRANCE

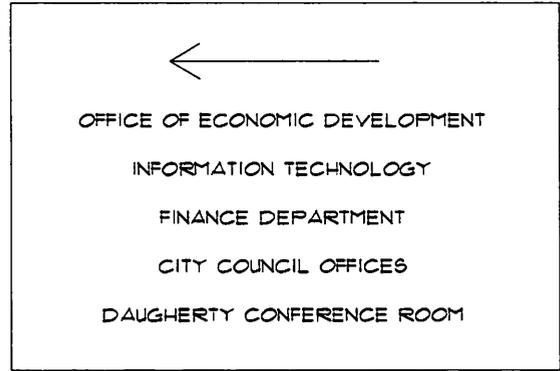


2ND FLOOR BY MAYOR'S OFFICE ENTRANCE - NORTH WALL

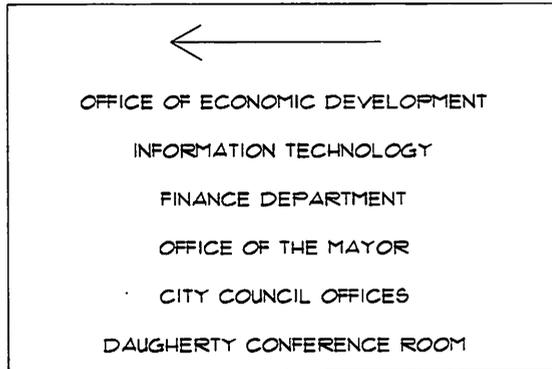


2ND FLOOR BY COUNCIL CHAMBERS ENTRANCE

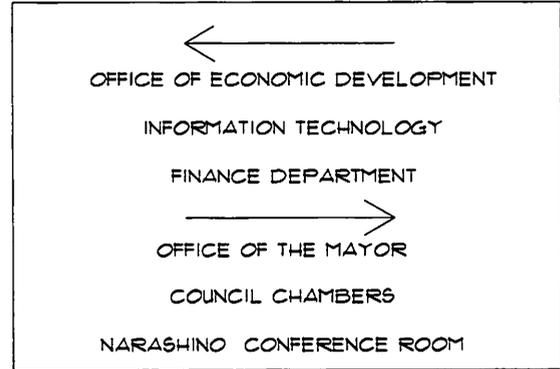

2ND FLOOR AT MAIN CORRIDOR

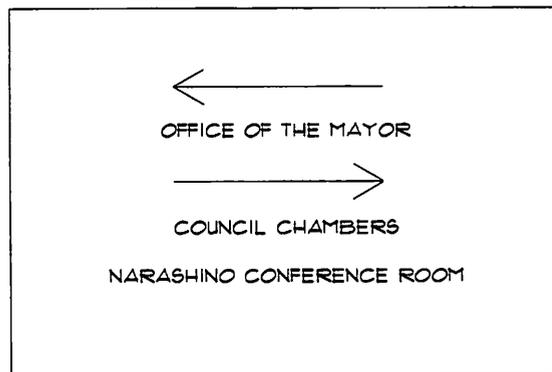

2ND FLOOR BY MAYOR'S OFFICE ENTRANCE - NORTH WALL

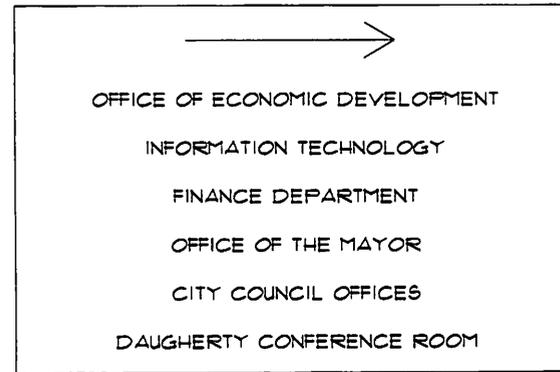

2ND FLOOR ELEVATOR LOBBY